



NOTICE TO THE PUBLIC

APPLICATION FROM DER CANNABIS VENTURES LTD. FOR A NON-MEDICAL CANNABIS RETAIL STORE LICENCE AT 4728 52ND STREET NW

Take notice that Council of the District of Chetwynd will be considering an application from Der Cannabis Ventures Ltd. for a Non-Medical Cannabis Retail Store Licence at 4728 52nd Street NW.


All persons who consider they may be affected by the Der Cannabis Ventures Ltd. for a Non-Medical Cannabis Retail Store Licence at 4728 52nd Street be provided an opportunity to make representations to Council at the Regular meeting scheduled for 4:30 p.m. on June 3, 2019. Written comments can also be submitted by 4:00 p.m. June 3, 2019 to the District of Chetwynd, fax: (250) 401-4101; email: d-chet@gochetwynd.com or mailed to PO Box 357, Chetwynd, BC V0C 1J0.

For further information, please contact the District Office at (250) 401-4100.

Carol Newsom
Corporate Officer

B.C. LAND SURVEYOR'S CERTIFICATE OF LOCATION
LOT 20 BLOCK A
DISTRICT LOT 398
PEACE RIVER DISTRICT PLAN 9830

Scale: 1:1000
 ALL DIMENSIONS SHOWN ARE IN METRES

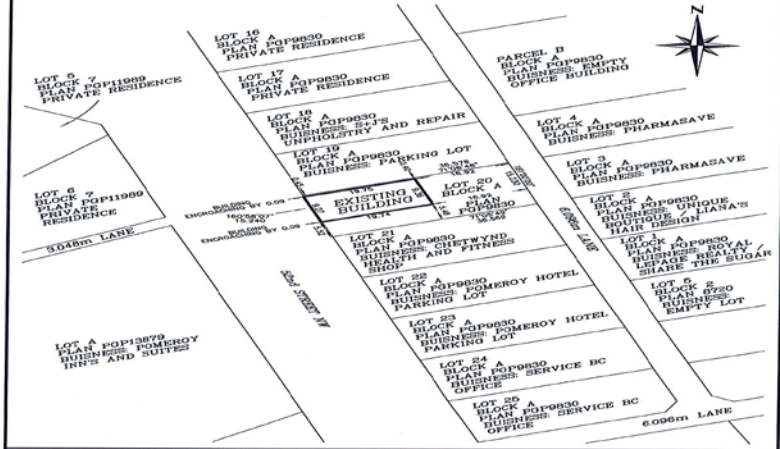

Boundaries shown are derived according to land title & survey authority records and field surveys. The document does not constitute a guarantee of accuracy.

This document is not valid unless the specific lot and block numbers are shown in red ink on a copy of this plan.

4728 - 2018 BC Land Survey Act

| | | |
|--------------------|--|---|
| FILE No. 2018-0430 | Tyron Land Surveying Ltd. 2018-0430 2018-0430-0001 www.tyroland.com | Surveyed The 20th Day of November, 2018 © 2018 B.C. LAND SURVEY ACT |
|--------------------|--|---|